


EXHIBIT C

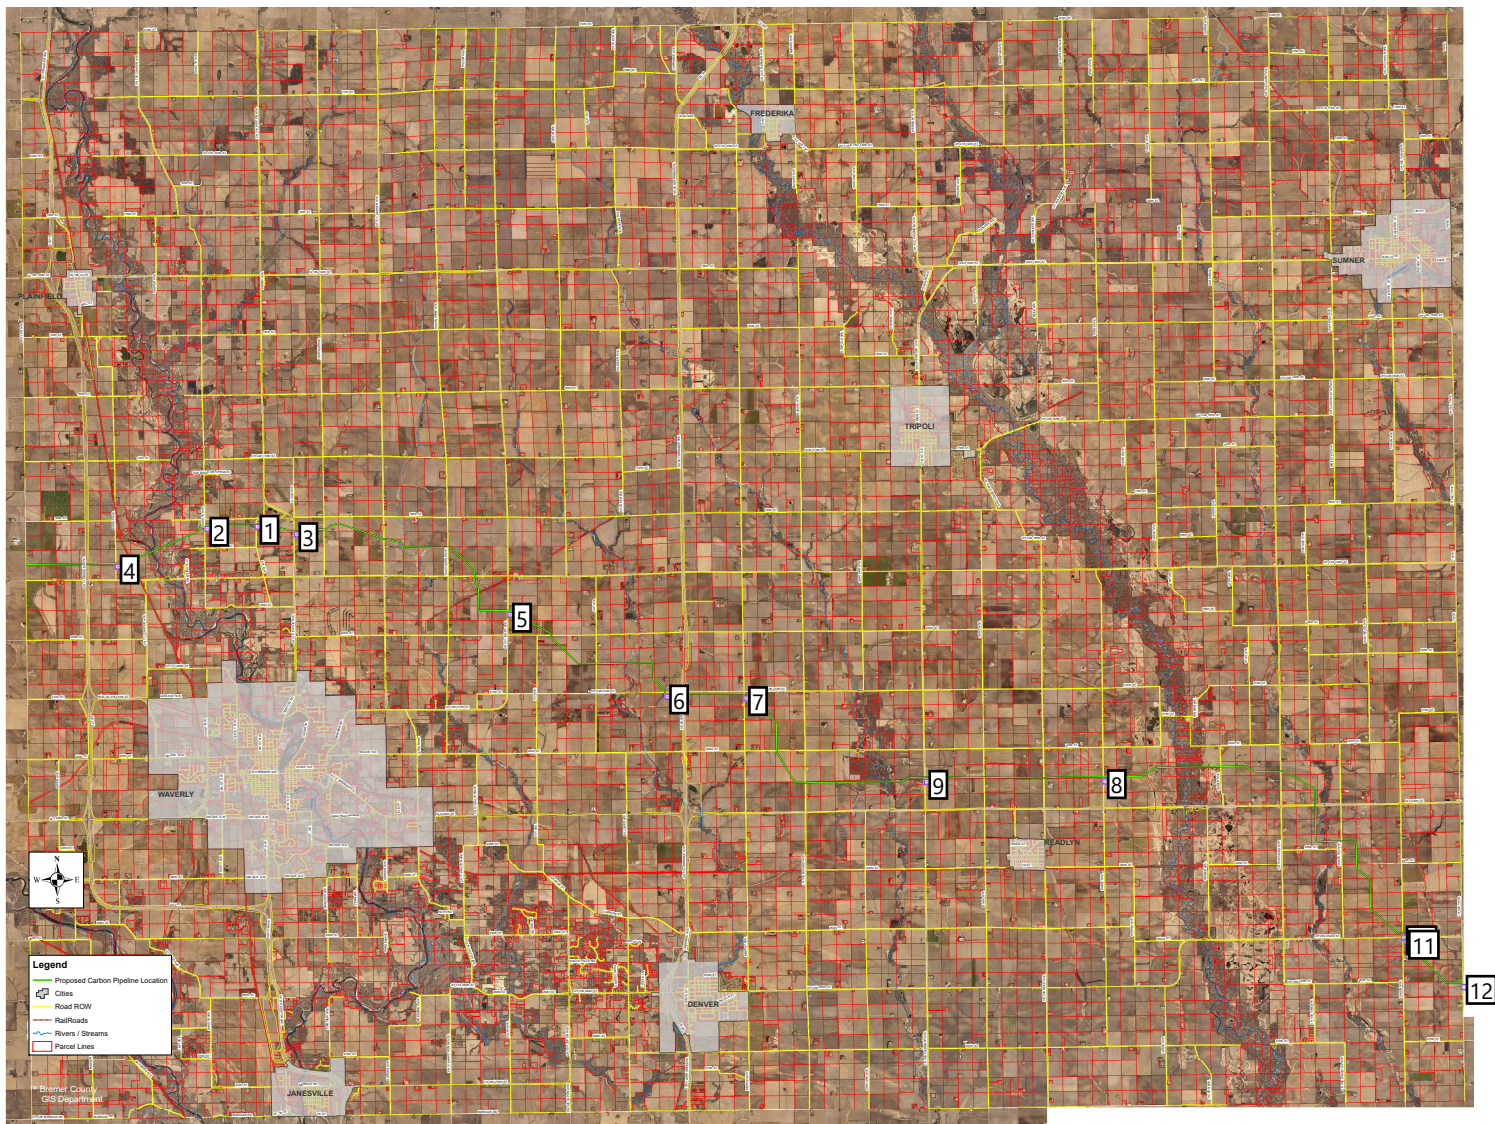

Summary of Comments on Proposed Carbon PipeLine Map 1-16-2025.pdf

Page: 1

	Number: 1	Author: Imoore	Subject: Sticky Note	Date: 1/17/2025 9:17:36 AM
	Less than 495 feet from county road intersection			
	Number: 2	Author: Imoore	Subject: Sticky Note	Date: 1/17/2025 9:17:16 AM
	Less than 495 feet from county road intersection			
	Number: 3	Author: Imoore	Subject: Sticky Note	Date: 1/17/2025 9:20:48 AM
	Likely less than 250 feet from culvert 1313-A			
	Number: 4	Author: Imoore	Subject: Sticky Note	Date: 1/17/2025 9:14:07 AM
	Less than 250 feet from county culvert crossing			
	Number: 5	Author: Imoore	Subject: Sticky Note	Date: 1/17/2025 9:25:20 AM
	Likely less than 250 feet from 1384			
	Number: 6	Author: Imoore	Subject: Sticky Note	Date: 1/17/2025 9:27:24 AM
	Less than 250 feet from culvert 1584			
	Number: 7	Author: Imoore	Subject: Sticky Note	Date: 1/17/2025 9:27:47 AM
	Less than 495 feet from county intersection			
	Number: 8	Author: Imoore	Subject: Sticky Note	Date: 1/17/2025 9:36:10 AM
	Less than 250 feet from county culvert 1829 and 1829-A			
	Number: 9	Author: Imoore	Subject: Sticky Note	Date: 1/17/2025 9:30:04 AM
	Verify if this is more than 495 feet from private ingress egress to 2252 Piedmont			
	Number: 10	Author: Imoore	Subject: Sticky Note	Date: 1/17/2025 9:38:59 AM
	Less than 495 feet from county road intersection			
	Number: 11	Author: Imoore	Subject: Sticky Note	Date: 1/17/2025 9:39:09 AM
	Less than 495 feet from county road intersection			
	Number: 12	Author: Imoore	Subject: Sticky Note	Date: 1/17/2025 9:40:15 AM
	Less than 495 feet from private ingress/egress			